Dart Aerospace Ltd. Friday, 3/23/2007 9:23:14 AM Date: Jean-Luc Menard User **Process Sheet** : CU-DAR001 Dart Helicopters Services **Drawing Name** : CLAMP Customer Job Number : 31448 **Estimate Number** : 12805 : NA Part Number : D35561 P.O. Number S.O. No. : 41/A : 3/23/2007 **Drawing Number** · D3556 UNDER REVIEW This Issue : BP0001 : NC Prsht Rev. **Project Number** : MA SMALL /MED FAB : U/R First Issue **Drawing Revision** : N'A **Previous Run** : NIA Material 2 Um: Each Due Date : 3/30/2007 Qty: Written By Checked & Approved By New Issue 07-03-23 JLM Comment : Est Rev:A **Additional Product** FOR ENGINEERING USE ONLY Job Number: Description: **Machine Or Operation:** Seq. #: 304/316 .063 Sheet M304S16GA 1.0 0.0378 sf(s)/Unit Total: 0.0756 sf(s)Comment: Qty.: 304/316 .063 Sheet 07 03 26 Batch: WIOI WATER JET 2.0 **Comment: FLOW WATER JET** 1-Cut as per Dwg D3556 M 01 03 26 Dwg Rev: UR Prog Rev: UK 2-Deburr if necessary INSPECT PARTS AS THEY COME OFF MACHINE 3.0 QC2 m 02 03 26 Comment: INSPECT PARTS AS THEY COME OFF MACHINE 4.0 QC8 SECOND CHECK . **Comment: SECOND CHECK** SMALL FAB 1 SMALL & MEDIUM FAB RESOURCE 1 5.0

Comment: SMALL & MEDIUM FAB RESOURCE 1

1-Form as per Dwg D3556


2-Tumble

Tools: w

83 07/03/24C

Date: Friday, 3/23/2007 9:23:14 AM User: 'Jean-Luc Menard **Process Sheet Drawing Name: CLAMP** Customer: CU-DAR001 Dart Helicopters Services Job Number: 31448 Part Number: D35561 Job Number: Description: Seq. #: **Machine Or Operation:** INSPECT WORK TO CURRENT STEP 6.0 QC5 ENGINEERING 07.03.76 APPROVAL 68 Comment: INSPECT WORK TO CURRENT STEP PACKAGING 1 PACKAGING RESOURCE #1 7.0 AIN prototype only Comment: PACKAGING RESOURCE #1 Identify and Stock CB 07.03.26 Location: FINAL INSPECTION/W/O RELEASE 8.0 QC21 Comment: FINAL INSPECTION/W/O RELEASE Job Completion

107/03/07 W6 07/03/07 U J. 03.27

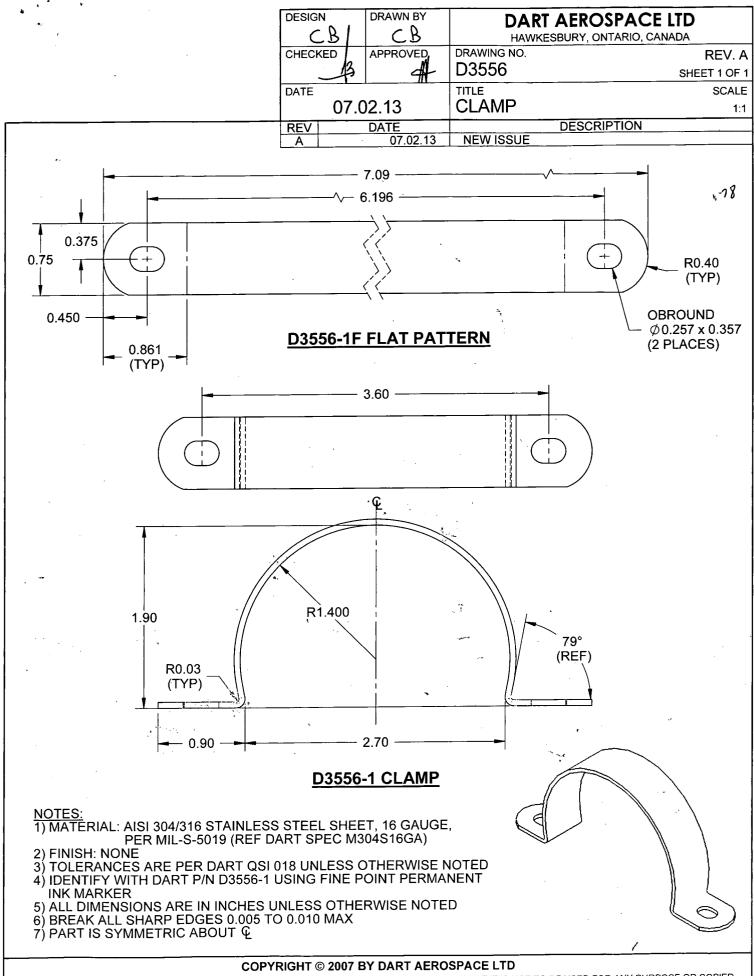

• *									
DART AEROSPACE LTD						Work Order:		31448	
Description: CIAWD						Part Number:		(b-1	
							Par	ge 1 of 1	
FIRST ARTICLE INSPECTION CHECKLIST								go 1 01 1	
FJ									
						rototype			
Inspection Sheet Drawing Dimension		Tolerance	Actual Dimension	Accept	Reject	ject Method of Inspection		Comments	
Α	\$0.257	10.006-0.001	0.257	<b>√</b>		vern	u		
В	.357	41-0.010	0.357	V		veril			
С	7.09	+1-0.030	7.09	1		UNN			
D	6.196	71-0.010	6.193	<b>V</b>		verni			
Е	0.455	41-0-010	0.450	1		Vern			
F	0.75	+1-0.030	0.756	\ <u>\</u>		VERN			
G	0.375	4-0.010	0.378	J		vern			
Н	RO.40	+1-0.030	RO.40	1		Vern	····		
1									
J									
K									
L								·	
М									
N					-				
0				ļ	<del> </del>				
P									
Q			ļ						
R				<u> </u>					
S									
					<del> </del>			*	
U									
V									
W				1	<del> </del>			***************************************	
X					<del> </del>		·		
Y									
Measured by: All Audited by:					_	Prototype Approva		II: N/A	
Date: 0326 Date: 010326						Date: N/A			
NEW CHANGE								Approved	
New Issue KJ/RF									